



**EXISTING
STAGE 1B**

STAGE 2A

LEGEND

- STORMWATER DRAINAGE PIPE
- SIDE ENTRY PIT
- MANHOLE
- ▲ HEADWALL
- DRAINAGE PIT AND 2 No. PIPES DRAINING TO KERB (REFER NOTE 3)
- REAR ALLOTMENT DRAINAGE PIT & PIPE REFER DRG-0006 FOR DETAILS
- GROUTED STONE PITCHING WITH A24 GEOFABRIC UNDERLAY (20m² NOM.)
- 20.2 DESIGN SURFACE CONTOURS (0.2m INTERVAL)
- 17.0 EXISTING SURFACE CONTOURS (0.2m INTERVAL)
- D EXISTING STORMWATER DRAINAGE
- E EXISTING ELECTRICAL
- S EXISTING SEWERAGE
- W EXISTING WATER RETICULATION

NOTES

1. REFER DRG. SS3000 FOR WEEPHOLE CONNECTION TO MANHOLES, SEPS AND HEADWALL DETAILS.
2. REFER STD DRG. SS3001 FOR TYPICAL TRENCH DETAILS.
3. REFER TYPE B STORMWATER LOT CONNECTION DETAIL ON STD DRG. SS3002. CONTRACTOR TO INSTALL 2 No. Ø100 uPVC PIPES WITH KERB ADAPTORS IN PLACE OF THE 100x150 RHS DRAINAGE PIPES.
4. REFER STD DRG SS3003-SS3007 FOR SIDE ENTRY PIT DETAILS

**AS CONSTRUCTED INFORMATION
CERTIFIED BY BMD URBAN PTY LTD**

SIGNED: RYAN DOHERTY DATE: 19.04.2022


WARNING

BEWARE OF SERVICES
 The locations of all existing services are approximate only and their exact position should be proven on site. No guarantee is given that all existing services are shown.

AS-CONSTRUCTED

REV	DATE	APPD	REVISION
3	14.09.22	RK	AS-CONSTRUCTED - REMOVAL OF STORMWATER CONNECTIONS
2	17.08.22	RK	AS-CONSTRUCTED
1	18.02.22	RK	AS-CONSTRUCTED
0	25.05.21	RK	CONTRACT DRAWINGS

SCALES AT A1

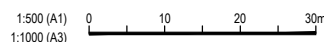

..d\0396624\LDC Logo_Mono.tif

Jacobs


ABN 37 001 024 095 and ACN 001 024 095
 Jacobs Group (Australia) Pty Ltd
 Level 2, 23-25 Parap Road
 Parap, DARWIN, NT 0820
 AUSTRALIA

Tel: +61 8 8982 4800
 Fax: +61 8 8982 4840
 Web: www.jacobs.com

CLIENT LAND DEVELOPMENT CORPORATION			
PROJECT SOUTHERN REGION - ALICE SPRINGS KILGARIFF SUBDIVISION STAGE 2A			
DRAWN TAB	DRAWING CHECK RK	REVIEWED R. KRAKE	APPROVED N. LEE LONG
DESIGNED TAB	DESIGN REVIEW RK	DATE 25.05.21	DATE 25.05.21

TITLE
**DRAINAGE PLAN
SHEET 1 OF 2**

SCALE AS SHOWN	DRAWING No. IW233900-2A-CI-DRG-0019	NTG DRAWING No. R20-3513	REV 3
-------------------	--	-----------------------------	----------

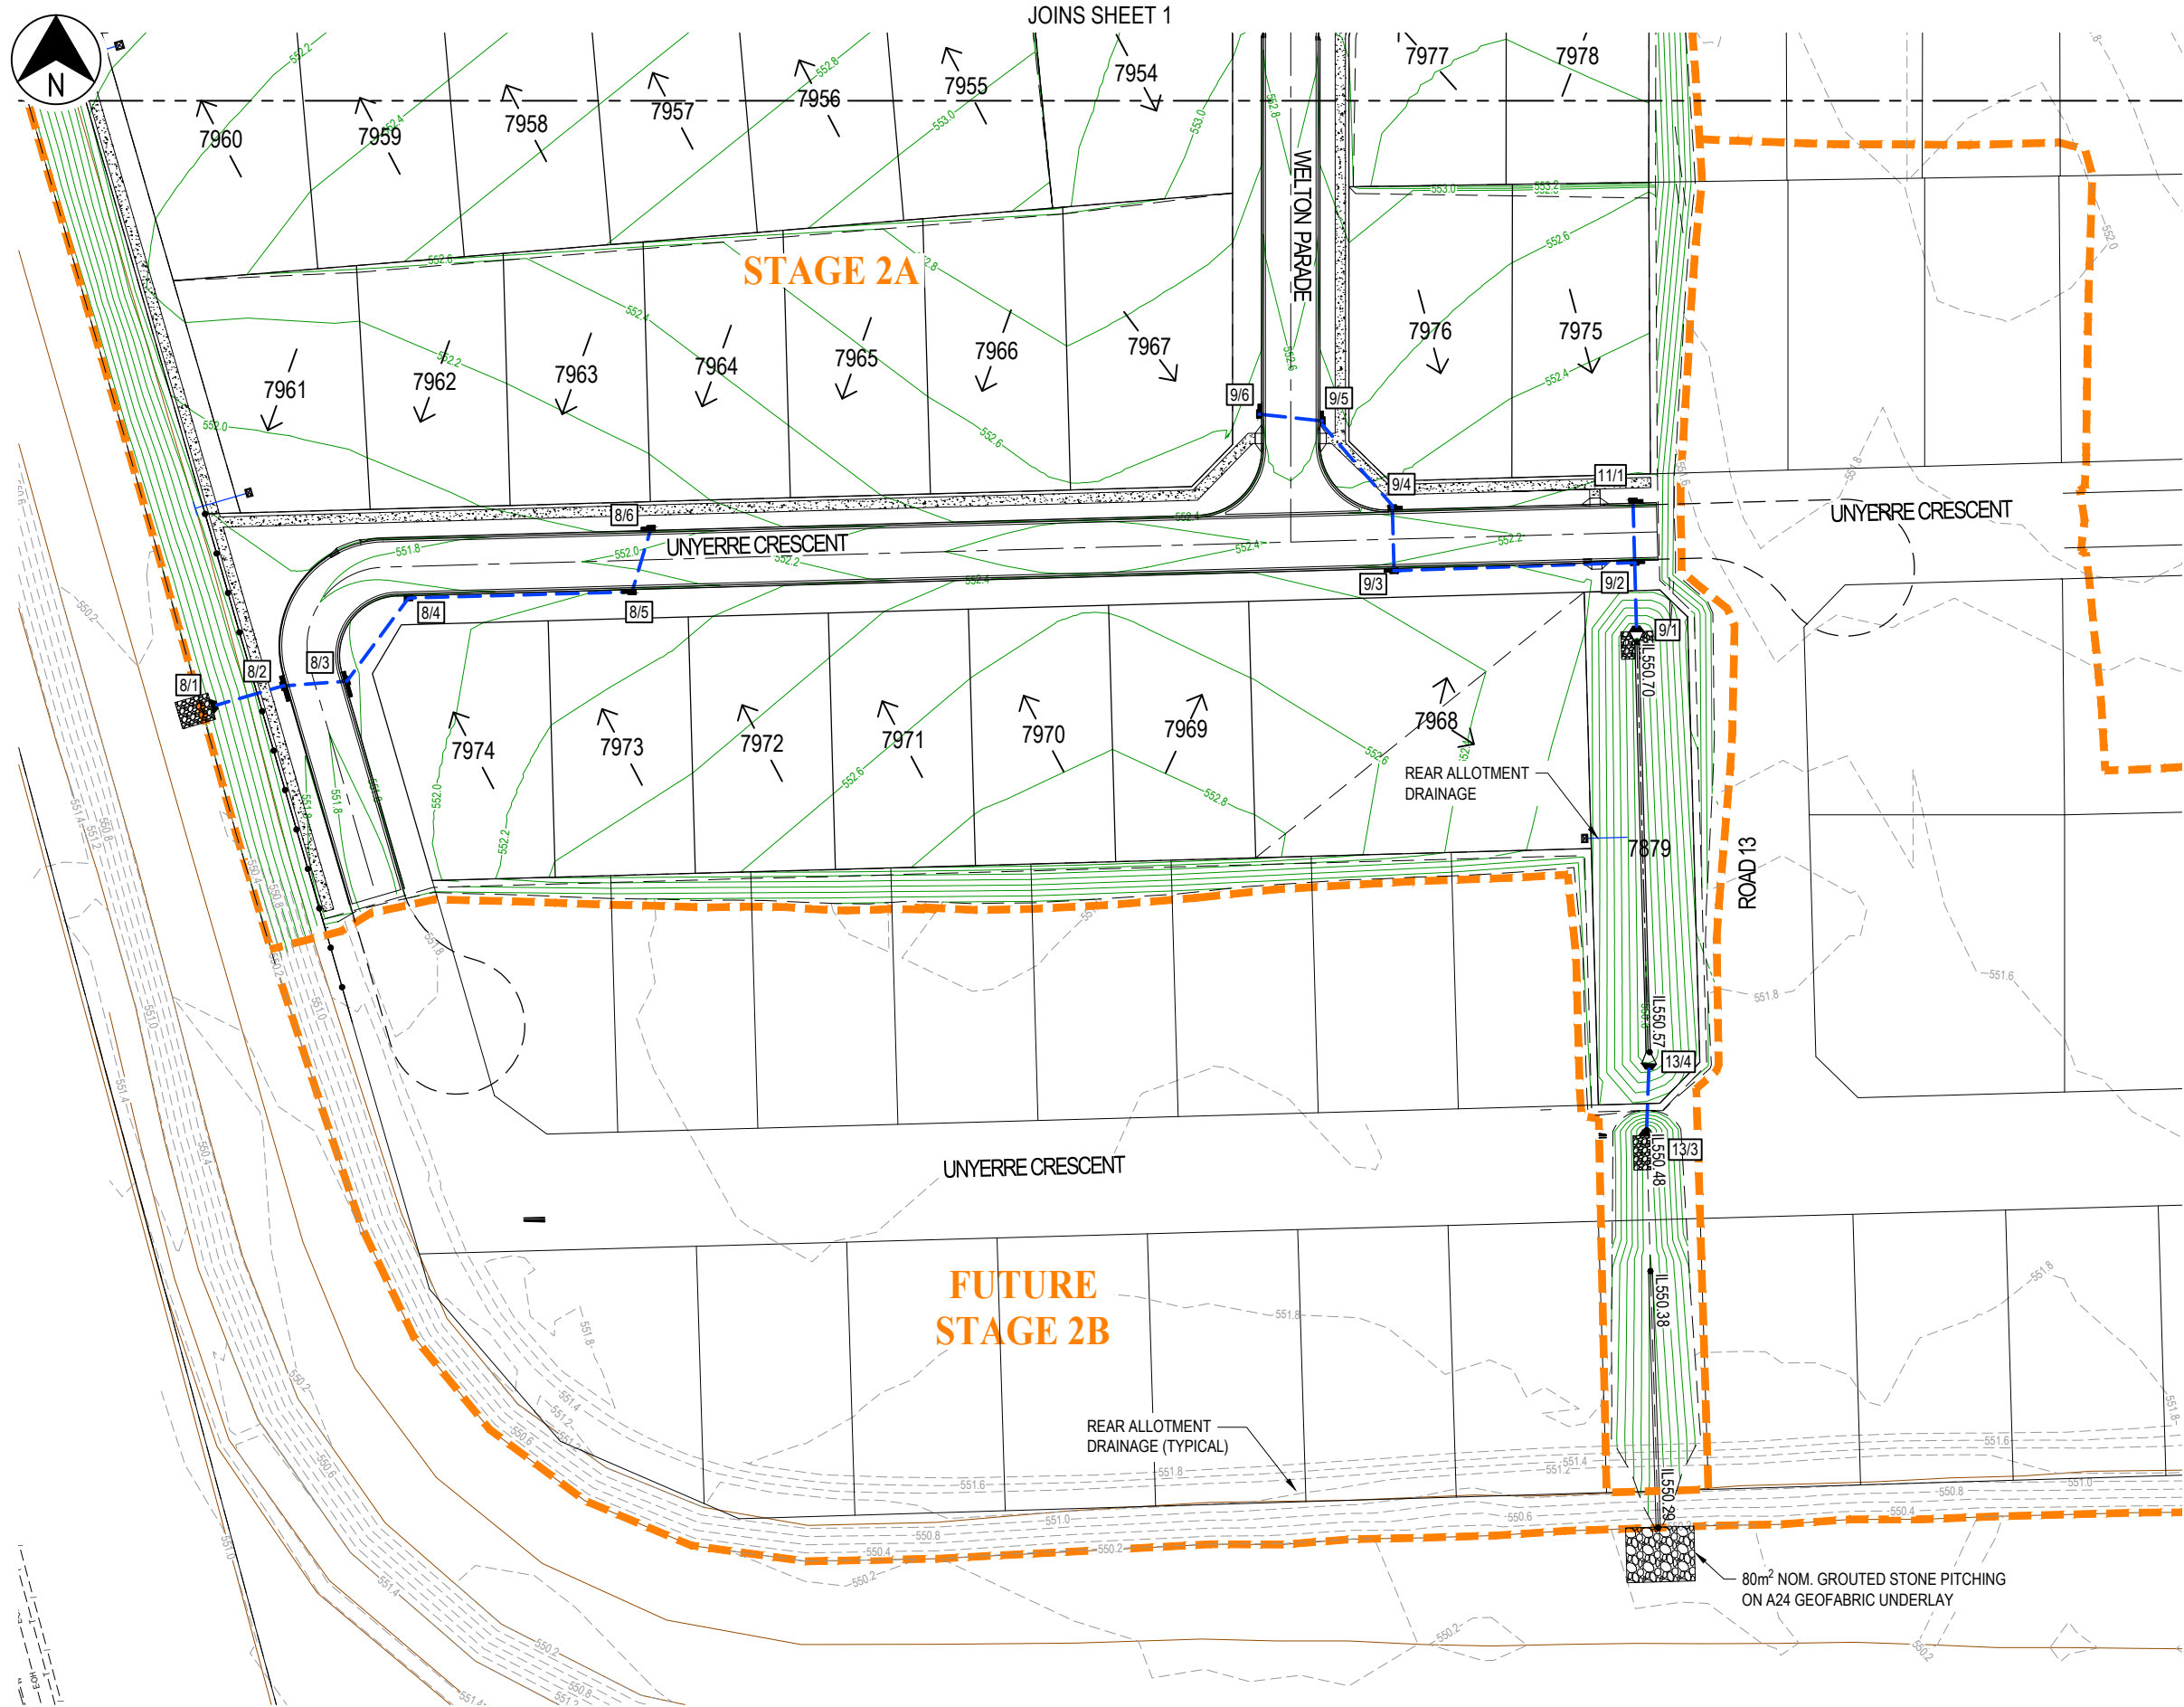


**AS CONSTRUCTED INFORMATION
 CERTIFIED BY BMD URBAN PTY LTD**
 SIGNED: RYAN DOHERTY DATE: 19.04.2022

**WARNING
 BEWARE OF SERVICES**
 The locations of all existing services are approximate only and their exact position should be proven on site. No guarantee is given that all existing services are shown.

AS-CONSTRUCTED

REV	DATE	APP'D	REVISION
2	14.09.22	RK	AS-CONSTRUCTED - REMOVAL OF STORMWATER CONNECTIONS
1	18.02.22	RK	AS-CONSTRUCTED
0	25.05.21	RK	CONTRACT DRAWINGS

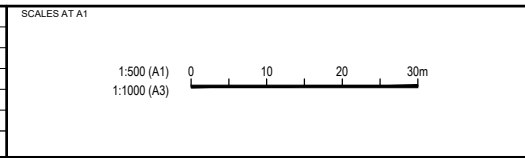

..d0396624\LDC Logo_Mono.tif

Jacobs
 ABN 37 001 024 095 and ACN 001 024 095
 Jacobs Group (Australia) Pty Ltd
 Level 2, 23-25 Parap Road
 Parap, DARWIN, NT 0820
 AUSTRALIA
 Tel: +61 8 8982 4800
 Fax: +61 8 8982 4840
 Web: www.jacobs.com

CLIENT	LAND DEVELOPMENT CORPORATION		
PROJECT	SOUTHERN REGION - ALICE SPRINGS KILGARIFF SUBDIVISION STAGE 2A		
DRAWN	DRAWING CHECK	REVIEWED	APPROVED
TAB	RK	R. KRAKE	N. LEE LONG
DESIGNED	DESIGN REVIEW	DATE	DATE
TAB	RK	25.05.21	25.05.21

TITLE		DRAINAGE PLAN SHEET 2 OF 2	
SCALE	DRAWING No.	NTG DRAWING No.	REV
AS SHOWN	IW233900-2A-CI-DRG-0020	R20-3514	2